IN RE: PETITION FOR ZONING VARIANCE * ZONING COMMISSIONER

3rd Councilmanic District

* OF BALTIMORE COUNTY * Case No. 90-186-A

Jacque Noah Petitioner

FINDINGS OF FACT AND CONCLUSIONS OF LAW

* * * * * * * * * *

The Petitioner herein requests a variance from Sections 1A04.3.B.5. and 1A00.3.3 to permit a sid yard setback of 20 feet in lieu of the required 50 feet, in accordance with Petitioner's Exhibit 1.

The Petitioner, Mr. Jacque Noah, appeared and testified. Also appearing on behalf of the Petitioner was Mr. Ross Daniels, a professional builder. There were no Protestants.

Testimony indicated that the subject property known as 12210 Park Heights Avenue, consists of 2 acres +/-, zoned R.C.5, and is improved with a single family dwelling.

Testimony indicated that the Petitioner desires to construct an attached 30 x 19 foot garage on the southern side of his home and a bedroom 16 x 18 feet on the northwest side. The Petitioner indic-ted that the garage will access his existing concrete driveway. He stated that the proposed location of the bedroom addition is the only practical location, in view of the existing septic system and the layout of his home.

An area variance may be granted where strict application of the zoning regulations would cause practical difficulty to the Petitioner and his property. McLean v. Soley, 270 Md. 208 (1973). To prove practical difficulty for an area variance, the Petitioner must meet the following:

PETITION FOR ZONING VARIANCE

The undersigned, legal owner(s) of the property situate in Baltimore County and which is described in the description and plat attached hereto and made a part hereof, hereby petition for a

of the Zoning Regulations of Baltimore County, to the Zoning Law of Baltimore County; for the following reasons: (indicate hardship or practical difficulty)

setback line. The current owner cannot construct a garage

addition on the house without a variance from the current

2) The only other place to construct a garage addition is on the north side of the house, but this impossible because

1) House was built by original owner on the southern building

Variance from Section 1Ao4.3.B.5 and 1Aoo.3.3(1975ed) to allow a side

yard setback of 20ft. in lieu of the required 50ft..

50 foot setback to a 20 foot setback.

TO THE ZONING COMMISSIONER OF BALTIMORE COUNTY:

ty for a permitted purpose or render conformance unnecessarily burdensome;

3) whether relief can be granted in such fash-

Anderson v. Bd. of Appeals, Town of Chesapeake Beach, 22 Md. App.

It is clear from the testimony that if the variance is granted, such use as proposed would not be contrary to the spirit of the B.C.Z.R. and

is clear that a practical difficulty or unreasonable hardship would result if the variances were not granted. It has been established that the requirements from which the Petitioner seeks relief would unduly restrict the use of the land due to the special conditions unique to this particular parcel. In addition, the variances requered will not be

Pursuant to the advertisement, posting of the property, and public hearing on this Petition held, and for the reasons given above, the relief requested should be granted.

County this // day of Accember, 1989 that the Petition for a

1) whether strict compliance with requirement would unreasonably prevent the use of the proper-

2) whether the grant would do substantial injustice to applicant as well as other property owners in the district or whether a lesser relaxation than that applied for would give substantial

ion that the spirit of the ordinance will be observed and public safety and welfare secured.

28 (1974).

would not result in substantial detriment to the public good. After due consideration of the testimony and evidence presented, it

detrimental to the public health, safety and general welfare.

THEREFORE, IT IS ORDERED by the Zoning Commissioner for Baltimore variance to permit a side yard setback of 20 feet in lieu of the required

MOTICE OF HEARING The Zoning Commissioner of Baltimore County, by authority of the Zoning Act and Regulations of Baltimore County will hold a

public hearing on the property identified herein in Room 106 of the County Office Building, to-cated at 111 W. Chesapeake Av-enue in Towson, Manyland 21204 Petition for Zoning Variance
Case number: 90-186-A
420' N of Walnut Avenue
12210 Park Heights Avenue
4th Election District
3rd Councilmanic
Petitioner(s):
Jacque Noah
Hearing Date: Tuesday,
Nov. 21, 1969 at 2:00 p.m. Variance: To allow a side yard granted, a building permit may be issued within the thirty (30) day appeal period. The Zoning Com-missioner will, however, entertain any request for a stay of the issuance of said permit during this period for good cause shown. Such request must be in writing and received in this office by the date of the hearing set above or presented at the hearing.

NOTE: If "PHASE II" of the "SNOW EMERGENCY PLAN" is in effect in Baltimore County on CERTIFICATE OF PUBLICATION

Oct 27, 1989 THIS IS TO CERTIFY, that the annexed advertisement was published in THE JEFFERSONIAN, a weekly nev spaper published in Towson, Baltimore County, Md., once in each of _____ successive

THE JEFFERSONIAN.

5. Zake Orlan

the above hearing date, the Hearing will be postponed. In the event xi snow, telephone 887-3391 to 1/2 J. ROBERT HAINES Zoning Commissioner of Baltimore County O/J 10/285 October 28

CERTIFICATE OF PUBLICATION

Bellimore County, by authority of the Zoning Act and Regulations of Bellimore County will hold a public hearing an the property identified herein in Floore 106 of the County Office Building, to called at 111 W. Cheespeake Averue in Towarn, Maryland 21204 as follows:

Patition for Zoning Variance Case number: 90-188-A 420' N of Wahrut Avenue 12210 Park Heights Avenue 4th Election District 3rd Councilments

Potitioner(s):

Jacque Nosh
Hearing Date: Tiseaday, Nov. 21, 1989 at 200 p.m.

Variance: To allow a side ward.

J. ROBERT HAMSE S. J. ROBERT HAINES
Zoning Commissioner of
Beltimore County
10/285 October 26

OWINGS MILLS TIMES.

PO 18386 neg M 34266 50 feet, in accordance with Petitioner's Exhibit 1, be and is hereby GRANTED, subject, however, to the following restrictions which are conditions precedent to the relief granted herein:

> 1) The Petitioner may apply for his building permit and be granted same upon receipt of this Order; however, Petitioner is hereby made aware that proceeding at this time is at his own risk until such time as the 30-day appellate process from this Order has expired. If, for whatever reason, this Order is reversed, the Petitioner would be required to return, and be responsible for returning, said property to its original condition.

2) The Petitioner shall not allow or cause the accessory structure to be converted to a second dwelling unit and/or apartment. The garage shall contain no living sleeping quarters, and no kitchen or bathroom facilities.

 Upon request and reasonable notice, the Petitioner shall permit a representative of the Zoning Enforcement Division to make an inspection of the subject property to insure compliance with this Order.

> Zoning Commissioner for Baltimore County

cc: Peoples Counsel

CERTIFICATE OF POSTING ZONING DEPARTMENT OF BALTIMORE COUNTY

ZONING DESCRIPTION

420 feet north of Walnut Avenue. Also being known as Lot 2, Section 1,

Folio 26. Also being known as 12210 Park Heights Avenue in the 4th

Election District, containing 1.99 acres (+ or -).

Valley Hills, as recorded in Baltimore County Land Records Plat Book 37,

Beginning on the west side of Park Heights Avenue at # distance of

District 4 th Posted for: Narrance	——————————————————————————————————————
Posted for: Navance	Date of Posting Morenbur 1, 198
Petitioner: Jasque Moak	
Petitioner: Jacque Monh Location of property: 120' 1 of Walnut Grenue	arenue, 12210 Park Height
Location of Signs: In front of 12210	Park Height avenue
Remarks:	; = +
Posted by 1: Grata Signature Number of Signa:	Date of return: Morember 3, 1989

Baltimore County Zoning Commissioner Office of Planning & Zoning Towson, Maryland 21204 (301) 887-3353 J. Robert Haines

Zoning Commussiones

Mr. Jacque Noah 12210 Park Heights Avenue Owings Mills, Maryland 21117

Re: Petition for Zoning Variance CASE NUMBER: 90-186-A 420' N of Walnut Avenue 12210 Park Heights Avenue 4th Election District - 3rd Councilmanic Petitioner(s): Jacque Noah

HEARING: TUESDAY, NOVEMBER 21, 1989 at 2:00 p.m.

Dear Mr. Noah:

Please be advised that \$157.35 is due for advertising and posting of the above captioned property.

Baltimore County Zoning Commisioner County Office Building 111 West Chesapeake Avenue Towson, Maryland 21204

Dennis F. Rasmussen County Executive

11400.4103 11/20.01 FIRE IL Abando (EES Quo Publillo alulta / moveldiallo 1 / \$107.35 LAST WIR OF CHIERE HOW

> 8 8 118 *** * 10735: a = 214F Please make checks payable to: Baltimore County

> > hearing date.)

Baltimore County Zoning Commissioner Office of Planning & Zoning Towson, Maryland 21204 (301) 887-3353 J. Robert Haines

October 13, 1989

NOTICE OF HEARING



The Zoning Commissioner of Baltimore County, by authority of the Zoning Act and Regulations of Baltimore County will hold a public hearing on the property identified herein in Room 108 of the County Office Building, located at 111 W. Chesapeake Avenue in Towson, Maryland as

Petition for Zening Variance CASE NUMBER: 90-186-A 420' N of Walnut Avenue 12210 Park Heights Avenue 4th Election District - 3rd Councilmanto Petitioner(s): Jacque Noah HEARING: TUESDAY, NOVEMBER 21, 1989 at 2:00 p.m. Variance: To allow a side yardsetback of 30 feet in lieu of the required 50 feet.

In the event that this Petition Is granted, a building permit may be issued within the crirty (30) day appeal period. The Zoning Commissioner will, receiver, entertain any request for a stay of the issuance of said permit during this period for good cause shown. Such request must be in writing and received in this office by the date of the hearing set above or $p_t e$ sented at the hearing.

t <u>NOTE:</u>
(If "PHASE II" of the "SNOW EMERGENCY PLAN" is in effect in Baltimore County on the above hearing date, the Hearing will be postponed. In the event of snow, telephone 887-3391 to confirm hearing date.)

> ZONING COMMISSIONER BALTIMORE COUNTY, MARYLAND

of the location of the drain field by Zoning Regulations. I, or we, agree to pay expenses of above Variance advertising, posting, etc., upon filing of this petition, and further agree to and are to be bound by the zoning regulations and restrictions of D. HAR Baltimore County adopted pursuant to the Zoning Law For Baltimore County. I/We do solemnly declare and affirm, under the penalties of perjury, that I/weo are the legal owner(s) of the property which is the subject of this Petition. Legal Owner(s): Contract Purchaser: Jacque Noah (Type or Print Name) (Type or Print Name) City and State 484-6424 dag Attorney for Petitioner: 12210 Park Heights Ave 356-2143 (Type or Print Name) Owings Mills Md. 21117 Name, address and phone number of legal owner, contract purchaser or representative to be contacted Ross Daniels 3209 Caves Rd. Owings Mills Md. Attorney's Telephone No.: _____ ORDERED By The Zoning Commissioner of Baltimore County, this _____ 581-0876 day of 5e pt 19 9 that the subject matter of this petition be advertised, as required by the Zohing Law of Baltimore County, in two newspapers of general circulation throughout Baltimore County, that property be posted, and that the public hearing be had before the Zoning Commissioner of Baltimore County in Room 106, County Office Building in Towson, Baltimore

ANAILABLE FOR HEARING

AVAILABLE FOR HEARING

MON./TUES./WED. - NEXT TWO FONTHS

OTHER

REVIEWED BY: CAM DATE 28 (2)

BALTIMORE COUNTY, MARYLAND

INTER-OFFICE CORRESPONDENCE

J. Robert Haines Zoning Commissioner DATE: November 3, 1989

Pat Keller, Deputy Director Office of Planning and Zoning

SUBJECT: Zoning Petition No. 90-186A Jacque Noah, Item 40

The Petitioner requests a /ariance to permit a side yard setback of 20 feet in lieu of the required 50 feet.


In reference to this request, Staff offers no comment.

If there should be any further questions or if this office can provide additional information, please contact Jeffrey Long in the Office of Planning at 887-3211.

PK:JL:ggl ZPVARIOU

11/5/89 mailed late comments pour

Baltimore County
Department of Public Works
Bureau of Traffic Engineering
Courts Building, Suite 405
Towson, Maryland 21204
(301) 887-3554

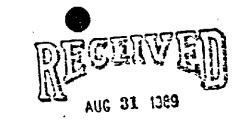

ZONING OFFICE

August 25, 1989



Mr. J. Robert Haines Zoning Commissioner County Office Building Towson, Maryland 21204

Dear Mr. Haines:

The Bureau of Traffic Engineering has no comments for items number 25, 27, 28, 29, 30, 31, 32, 33, 34, 35, 36, 38, 39,40, 41, and 42.

Very truly yours,

Michael S. Flanigan Traffic Engineer Associate II

MSF/lvw

Maryland Department of Transportation State Highway Administration

Richard H. Trainor Hal Kassoff

August 4, 1989


Mr. J. Robert Haines Zoning Commissioner County Office Building Towson, Maryland 21204 Att: James Dyer

Re: Baltimore County
Jacque Moah Property
Zoning meeting 8/8/89
W/S park Heights Avenue MD 129 420' north of Walnut Avenue Item #40

Dear Mr. Haines:

After reviewing the submittal for a variance to allow a side yard setback of 20' in lieu of the required 50', we find the plan

If you have any questions, contact Larry Brocato (333-1350).

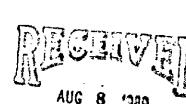

Very truly yours, Creston J. Mills. Jr. Chi

cc: Mr. J. Ogle

Creston J. Mills, Jr. Chief

Engineering Access Permits Division

JK/KEK

Baltimore County Fire Department 800 York Road Towson, Maryland 21204-2586

(301) 887-4500

Paul H. Reincke Chief

Gentlemen:

AUGUST 11, 1989



J. Robert Haines
Zoning Commissioner
Office of Planning and Tening
Baltimore County Office Euilding
Towson, MD 21204

JACQUE NOAH RE: Property Owner:

420' N OF WALNUT AVENUE Location: Zoning Agenda: AUGUST 8, 1989

Item No.: 40


Pursuant to your request, the referenced property has been surveyed by this Bureau and the comments below are applicable and required to be corrected or incorporated into the final plans for the property.

5. The buildings and structures existing or proposed on the site shall comply with all applicable requirements of the National Fire Protection Association Standard No. 101 "Life Safety Code", 1988 edition prior to occupancy.

REVIEWER: Calt Captelly 6-11-19 Ap
Planwing Group
Special Inspection Division

NOAH Residence

BEGINNING ON THE WEST SIDE OF PARK HEIGHTS AVE. AT A DISTANCE OF 420 FEET NORTH OF WALNUT AVE.. ALSO BEING KNOWN AS LOT 2 SECTION 1 VALLEY HILLS, AS RECORDED IN SALTIHORE COUNTY LAND RECORDS PLAT BOOK 37, FOLIO 26, * ALSO BEING KNOWN AS 12210 PARK HEIGHTS AVE, IN THE 4TH: ELECTION DISTRICT.

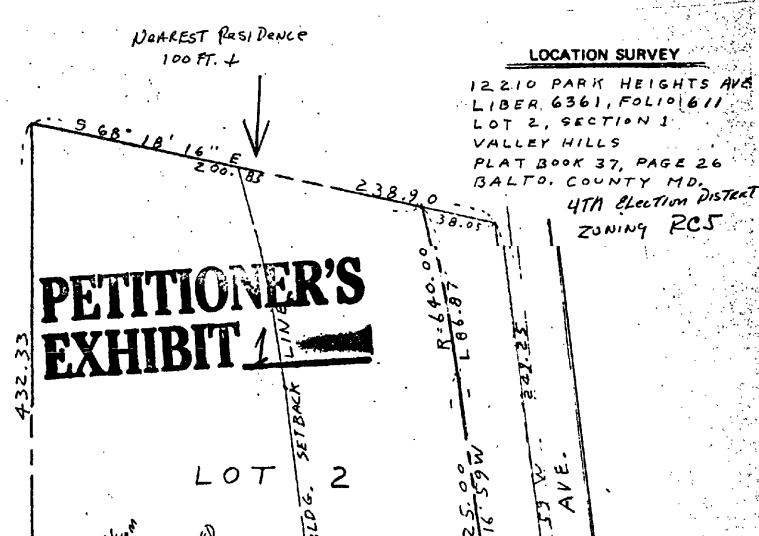

My telephone number is (301)______333-1350____

Teletypewriter for impaired Hearing or Sp. ech 383-7555 Baltimore Metro - 565-0451 D.C. Metro - 1-800-492-5062 Statewide Toll Free 707 North Caivert St., Baltimore, Maryland 21203-0717